

C:\Users\Jerry\Desktop\Market-notelcopy-2549889.jpg

660 4th Street  
Suite 255  
San Francisco, CA 94107  
Phone 805-884-9325  
Fax 415-354-3502




| revision schedule |                 |        |
|-------------------|-----------------|--------|
| #                 | Description     | Date   |
| 1                 | Plan Check Revs | 5/5/14 |

**CARNICERIA LA FAVORITA**  
17484 HWY 12  
SONOMA, CA. 95476

**PROPOSED SITE PLAN**

12.04/13

**A1.2**

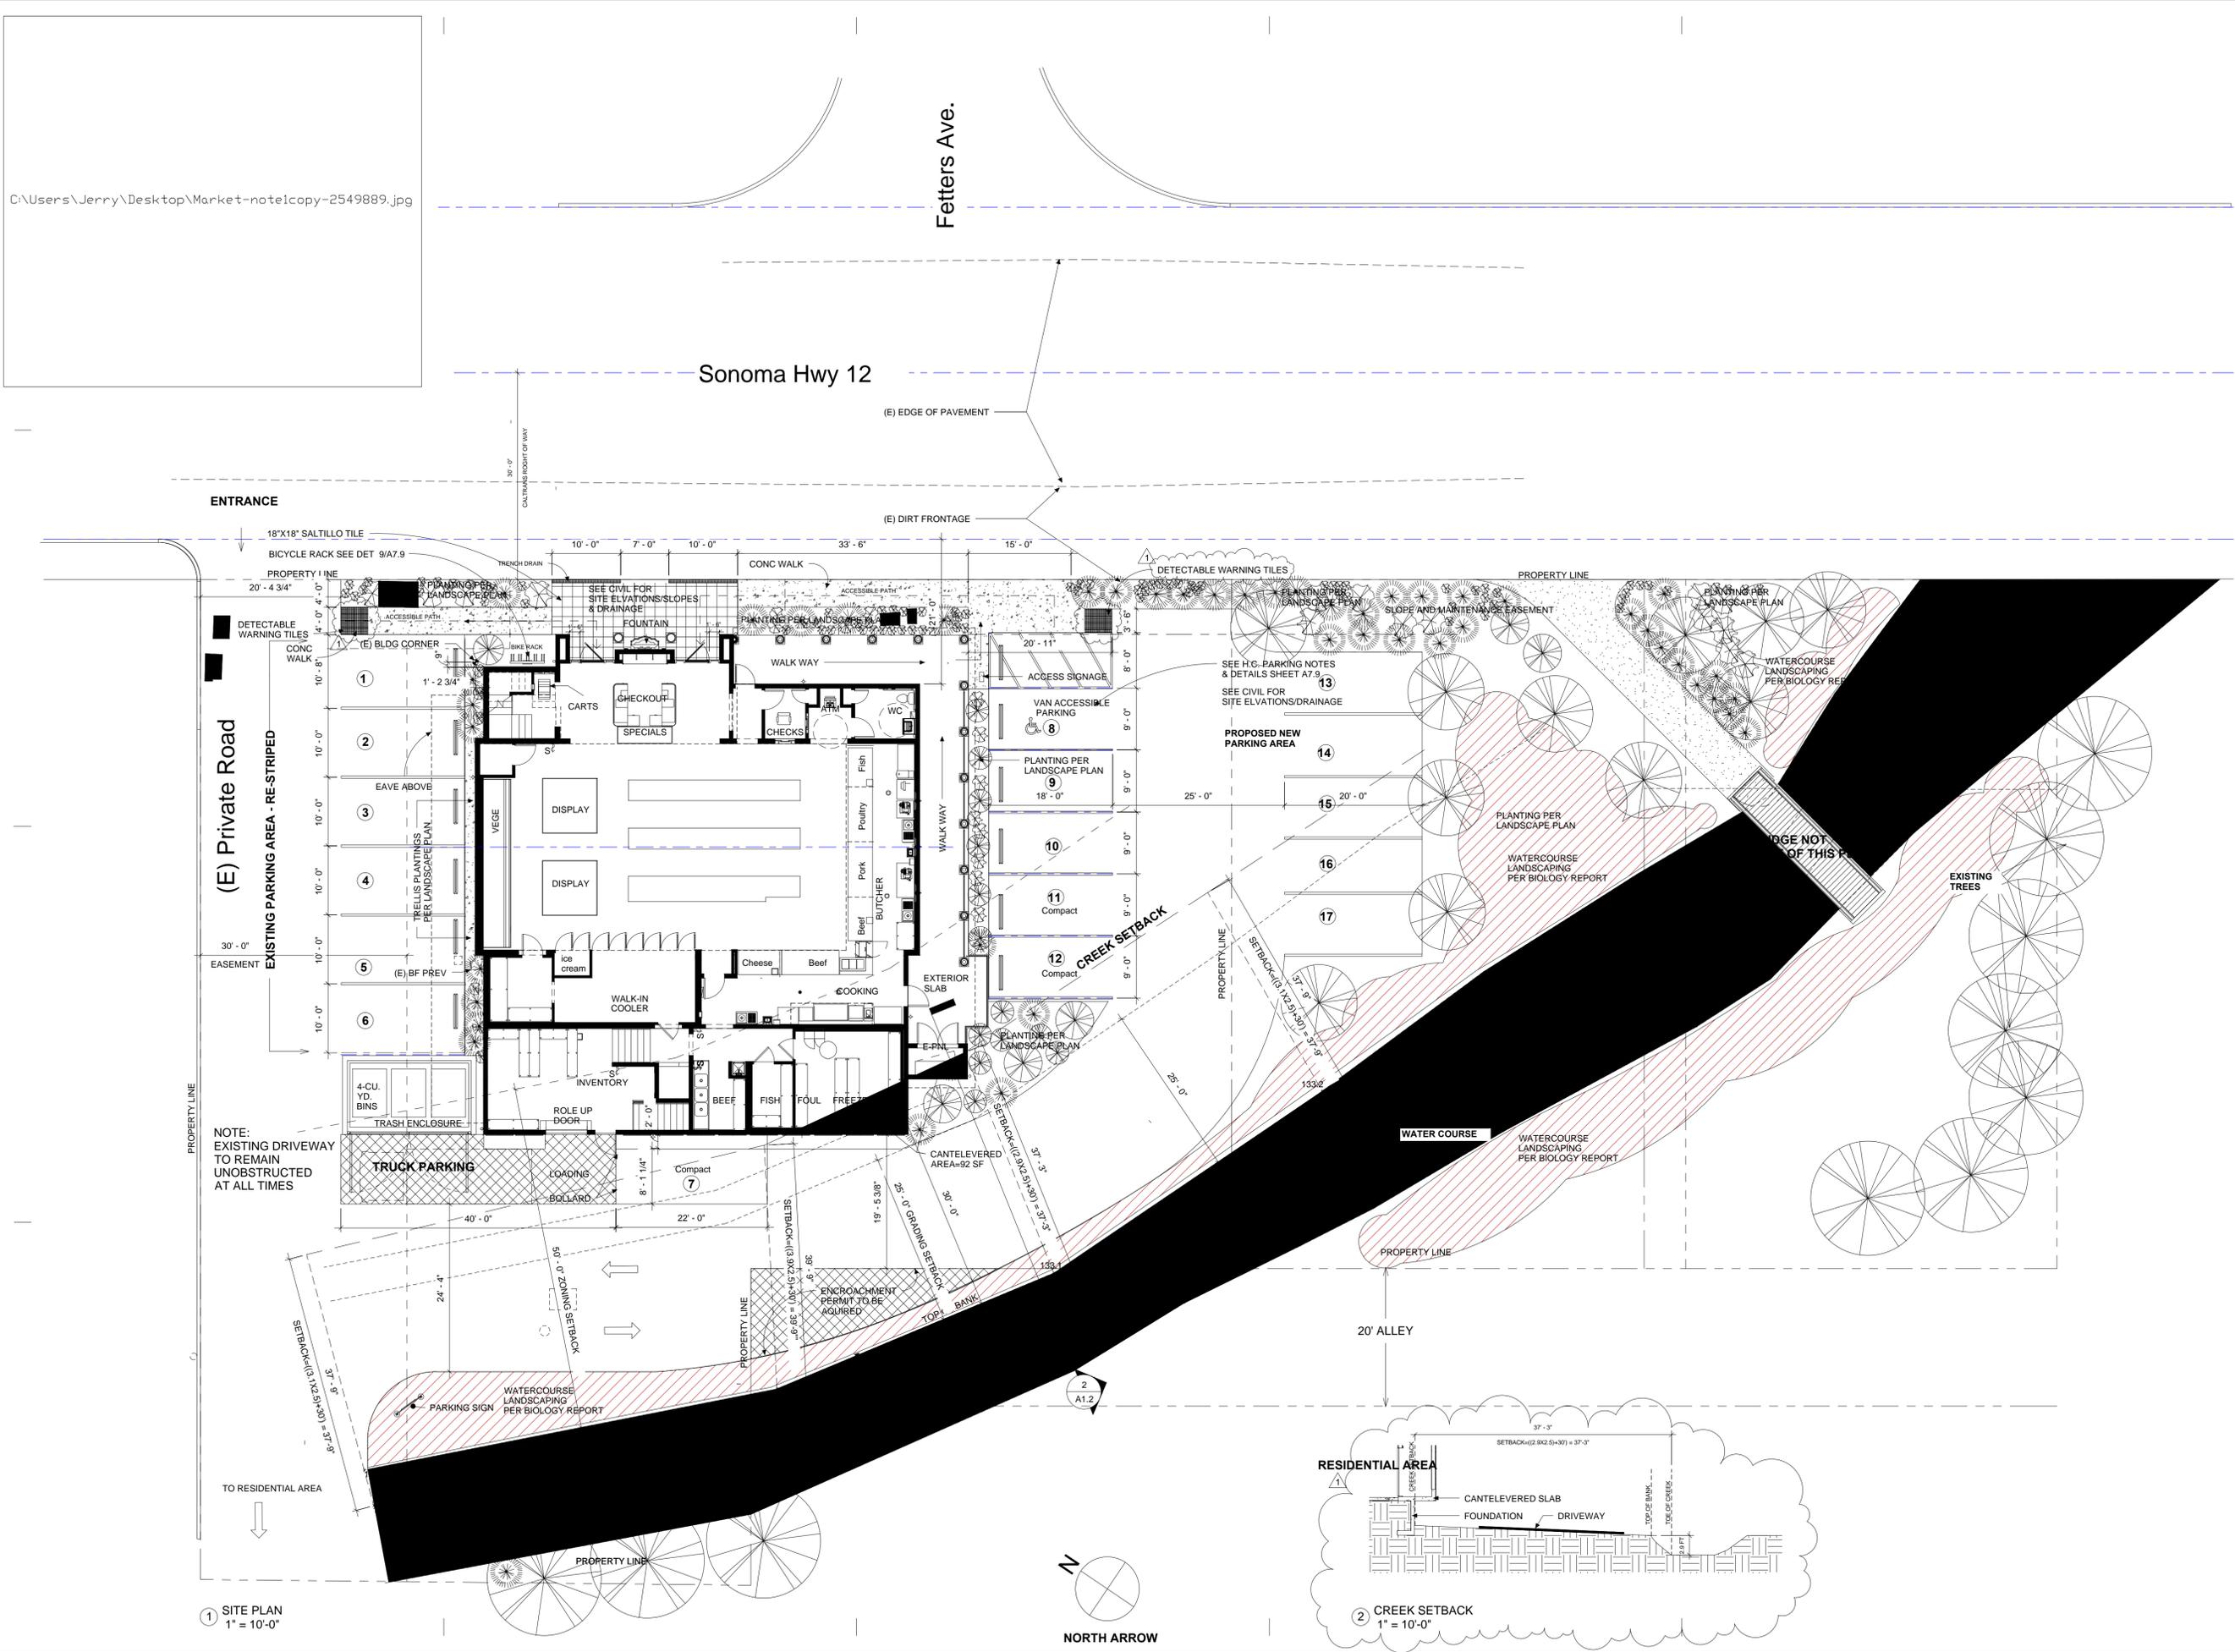

ENTRANCE

(E) Private Road

Fetters Ave.

Sonoma Hwy 12

NOTE:  
EXISTING DRIVEWAY  
TO REMAIN  
UNOBSTRUCTED  
AT ALL TIMES

1 SITE PLAN  
1" = 10'-0"

