


Approver

1/2" = 1'-0"

LAYOUT, BLOCKOUTS, INSULATION, PICK & BRACE INSERTS ONLY!

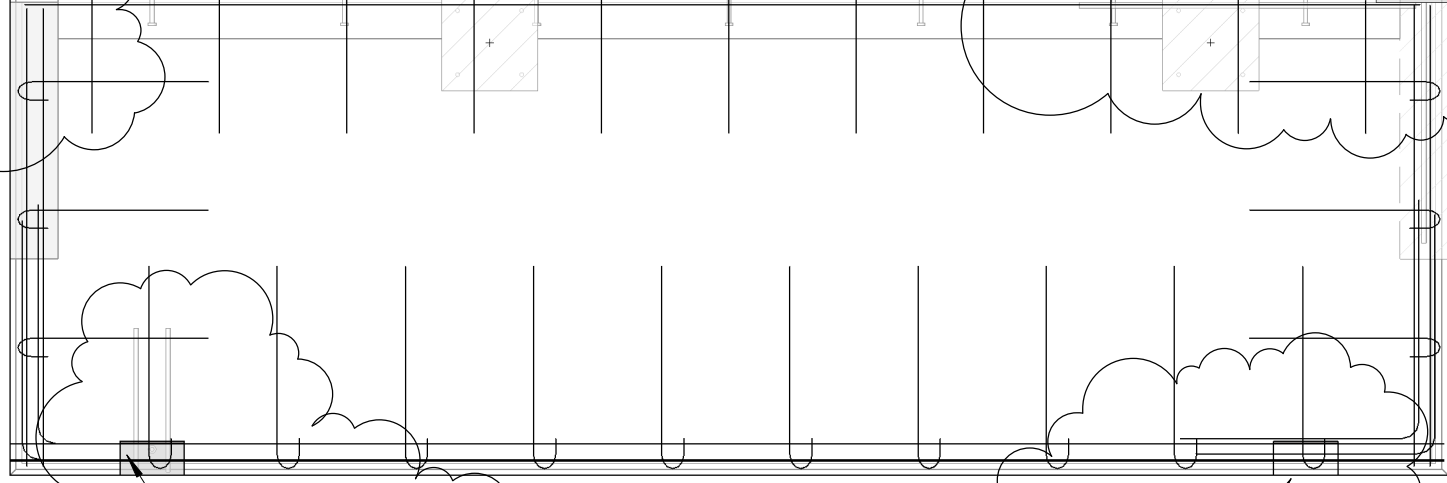

L4"x3"x3/8"x0'-8" w/
2-1/2"øx1'-6" DBA &
1-1/2"øx0'-3 1/2" HAS
(RECESS 1/4")
L-01

missing L-01
because it is
assembly "L-01"

PL 1/2"x8"x0'-9" w/
2-#5x2'-6" A706 vert. @
2 1/2" & 2-#6 x 3'-6" A706
horiz. @ 4" (RECESS 1")
P-02

There should be a P-02 embed here but
it is the embed that is used as the P-02
assembly so it is not included.

1/2" = 1'-0"

REINFORCING / STRAND / EMBEDS ONLY!

DESIGN INFORMATION

Panel Type: _____
 Strand Type: 270 KSI LOW-RELAX
 Strand Size: 1/2"ø in Structure
 Quantity of Strand: _____
 Design Camber @ Release (Midspan): N/A
 Design Jacking Force: 31,000 lbs
 Strength Required @ 28 Days (f'c): 5,000 PSI
 Strength Required @ Release (f'ci): 3,000 PSI

PRODUCTION APPROVAL

Plan Checker _____ Date 12/06/11
 Project Manager _____ Date _____
 Plan Supervisor _____ Date _____

AS-CAST APPROVAL

Quality Control _____ Date _____



Lydig Construction, Inc.

11-03-0621

Sheet

**Watson Structural
Engineering**

1062 NW Redwing Dr.
Oak Harbor, Washington 98277