


All designs are the sole property of PDM International Pty Ltd and may not be used without their written permission.

Figured dimensions only are to be used for Contractor and any scaling of the drawing will be at the Contractor's risk.

Contractor one to verify all dimensions on site and any discrepancies shall be addressed in writing to the office. Confirmation to be requested prior to the commencement of work. Otherwise the contractor shall bear full responsibility for any associated cost. Any variations deemed necessary shall be referred to PDM for approval prior to proceeding.

North

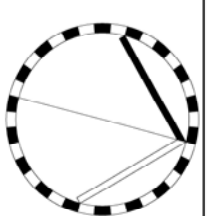

**FURNITURE LEGEND**

FOR ALL LOOSE FURNITURE AND WORKSTATION DETAILS REFER TO FFE SCHEDULE.

ALL LOOSE FURNITURE TO BE ORDERED BY PDM INTERNATIONAL. DELIVERY, PLACEMENT AND ON-SITE CO-ORDINATION TO BE THE RESPONSIBILITY OF THE CONTRACTOR.

CUSTOM FITTED FURNITURE SHOWN HATCHED - REFER TO JOINERY DETAIL DRAWINGS - RESPONSIBILITY OF CONTRACTOR.


COMMS EQUIPMENT (RACKS ETC.) TO BE SUPPLIED AND INSTALLED BY SUNGARD.

CONTRACTOR TO INSTALL = COMMISSIONS ALL ELECTRICAL EQUIPMENT + WHITE GOODS. PARTY RESPONSIBLE FOR PURCHASING EQUIPMENT + WHITE GOODS TO BE CONFIRMED.

**NOTE:**

⊕ CORE HOLES TO PROVIDE POWER SERVICES TO: T2, T3, T4, T5, AND RECEPTION COUNTER. LOCATION TO BE CONFIRMED BY ENGINEER.

WORKSTATION SCREENS TO BE (F12) UNLESS OTHERWISE NOTED WITH (F7)

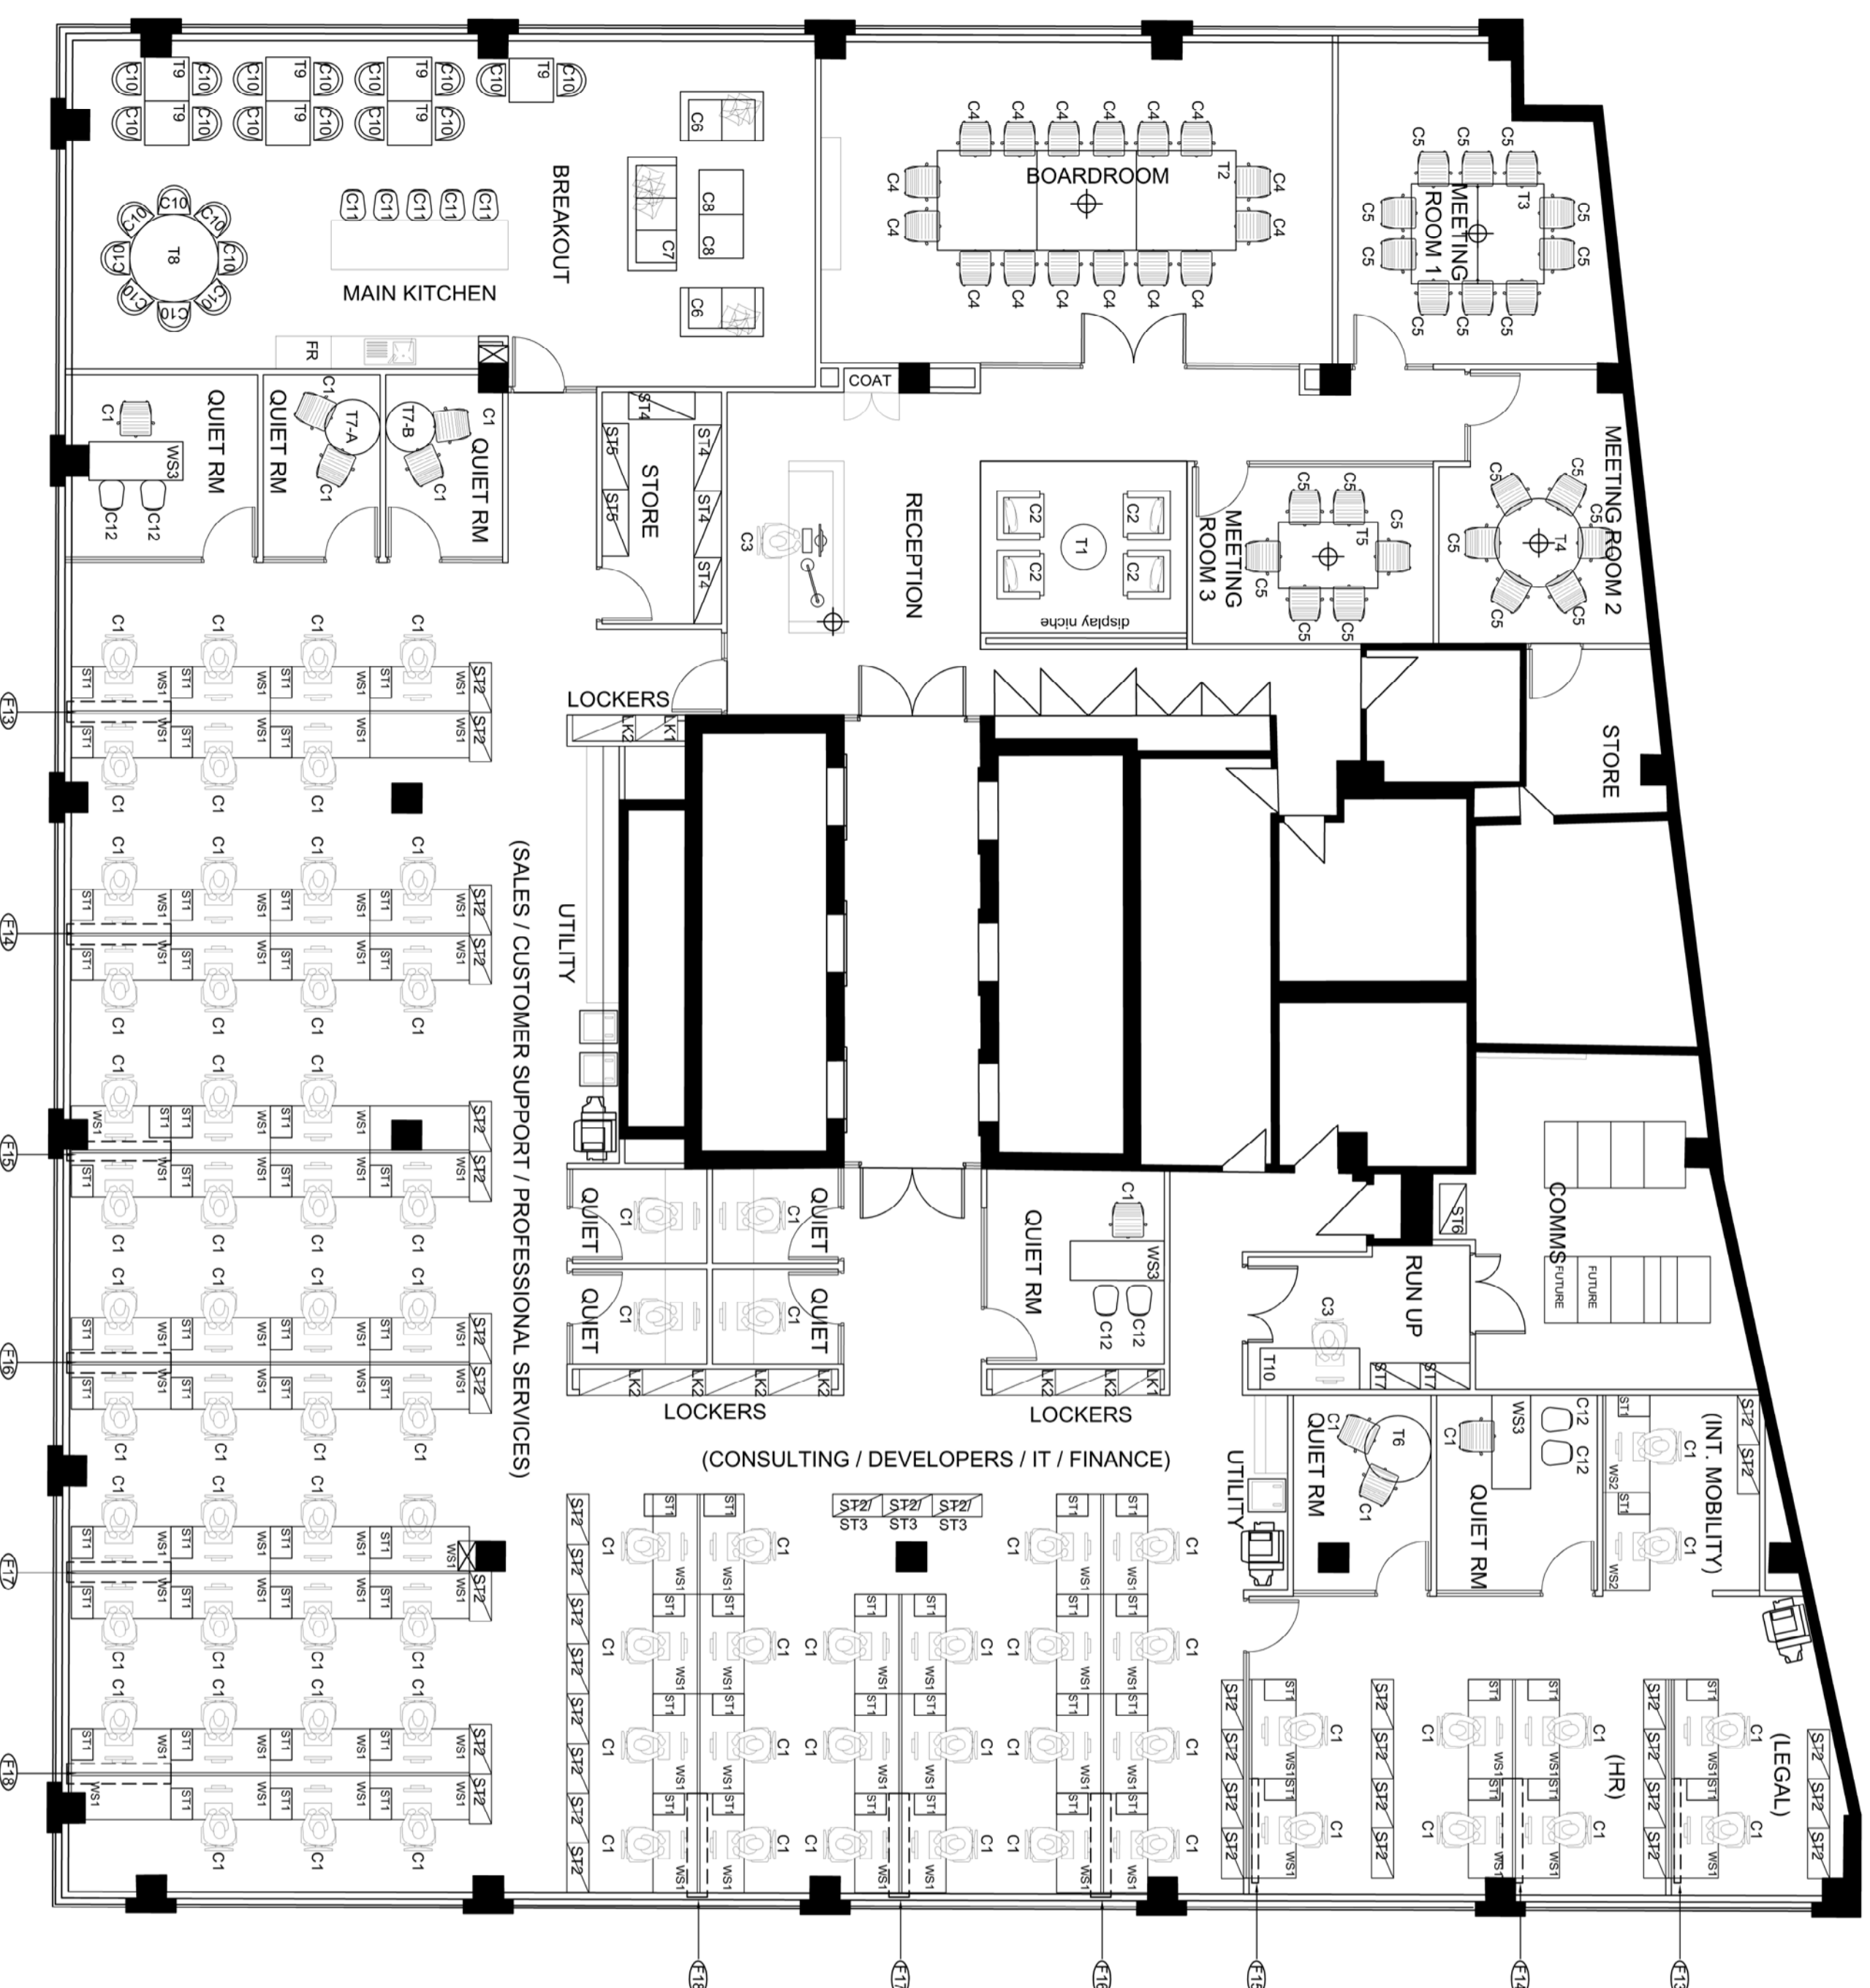

**01 FURNITURE PLAN**

SCALE 1:100 @ A2



JOB# PDM/29/213 SCALE 1:100@A2  
DATE 04.10.12 DWG# FT\_12

Client SUNGARD SYDNEY  
Level 12, 55 CLARENCE STREET  
SYDNEY, NSW AUSTRALIA

Interior Designer MICHELLE RYDER  
**PDM IN+ERNATIONAL**  
Level 1, 248 Kent St, Sydney NSW Australia 2000  
T 0297297 6405, WWW.PDMDESIGN.COM  
BANGKOK BEIJING CHENGDEU HONGKONG JAKARTA KUALA LUMPUR  
SEOUL SHANGHAI SINGAPORE SYDNEY

PROJECT SUNGARD SYDNEY  
NEW OFFICE

APPROVED .....  
AUTHORIZED FOR ISSUE .....  
REVIEWED .....  
PROJECT MANAGER RH  
PROJECT ENGINEER  
CHECKED ..... MR  
DESIGNED/DRAWN CS

**DRAWING TITLE**  
FURNITURE PLAN

Rev No.	Revision note	Date
A	ISSUE FOR APPROVAL	08.10.12
B	APPROVED PLAN.	09.10.12
C	ISSUED FOR PRICING	11.10.12
D	ISSUED FOR TENDER	19.10.12
E	ISSUE FOR INFORMATION.	30.10.12
F	ISSUE FOR INFORMATION.	30.10.12
G	ISSUE FOR CDC.	30.10.12
H	ISSUE FOR CONSTRUCTION.	12.11.12
I	ISSUE FOR CONSTRUCTION.	21.11.12
J	ISSUE FOR CONSTRUCTION.	23.11.12
K	ISSUE FOR CONSTRUCTION.	07.12.12
L	AS BUILT.	21.12.12