



FLOOR PLAN BLDG 214

SCALE: 1/8" = 1'-0" 1168 sqft ADDITION

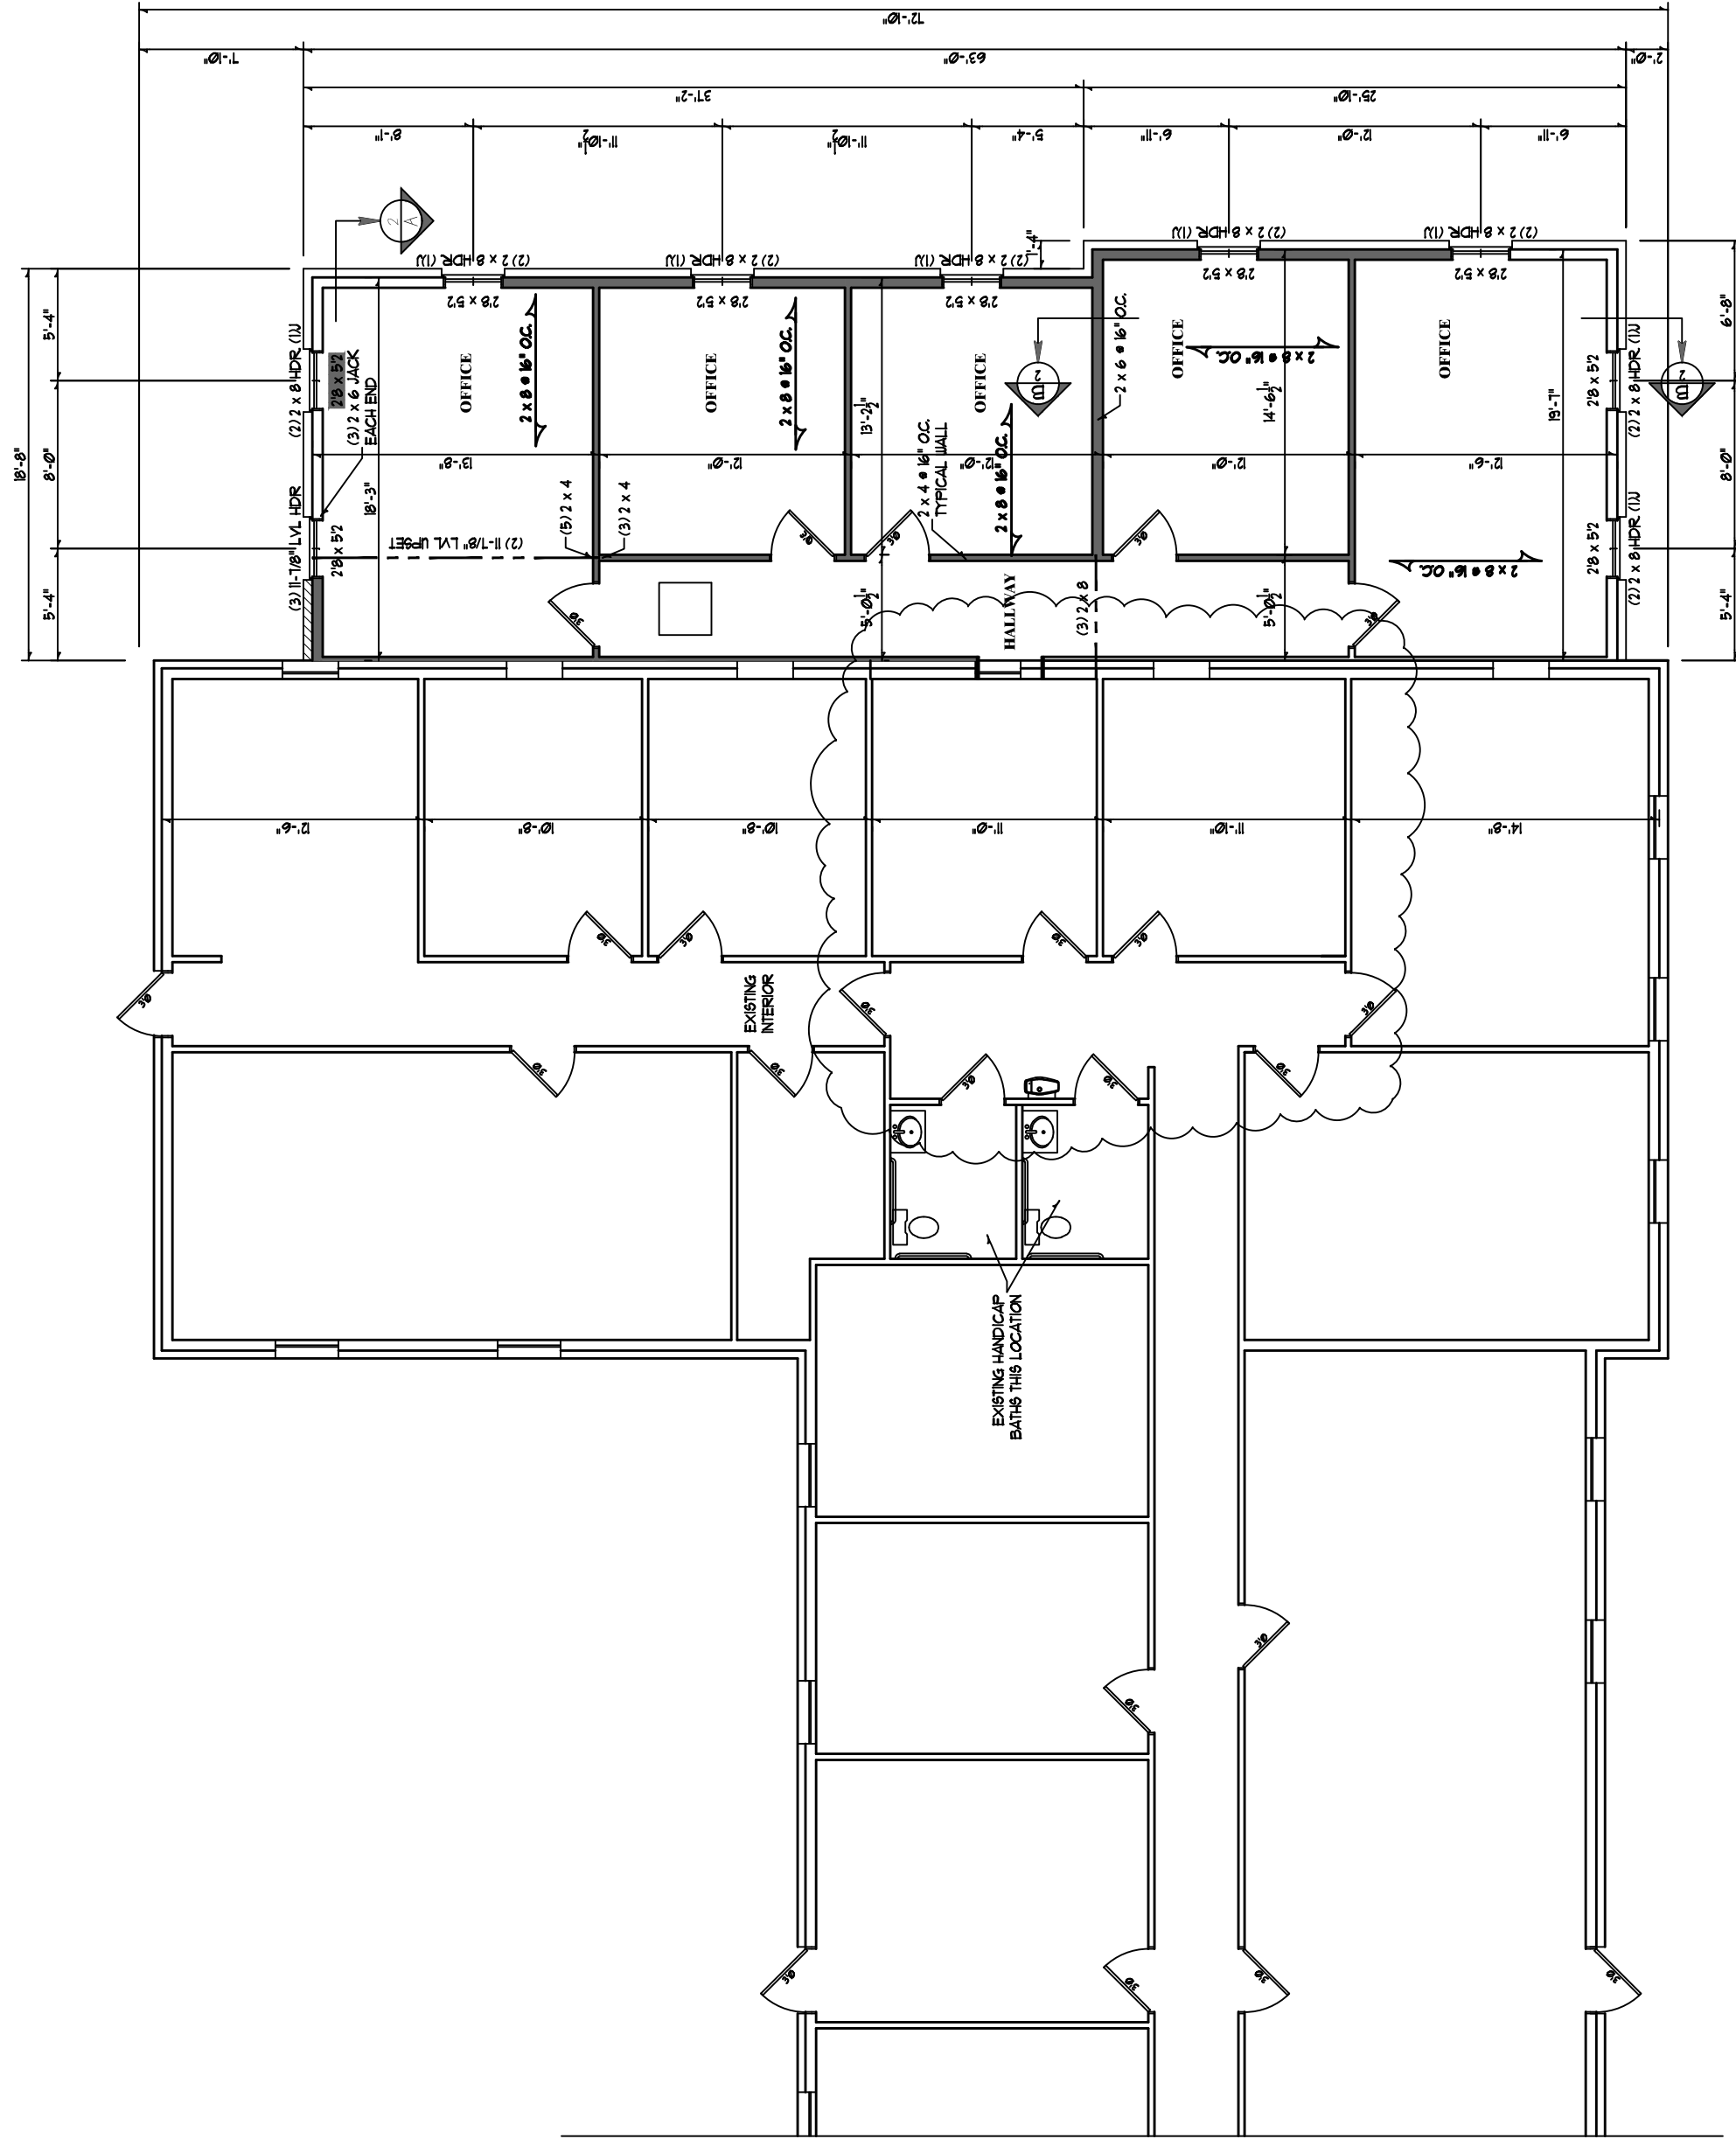



FLOOR PLAN BLDG 216

SCALE: 1/8" = 1'-0" 1168 sqft ADDITION

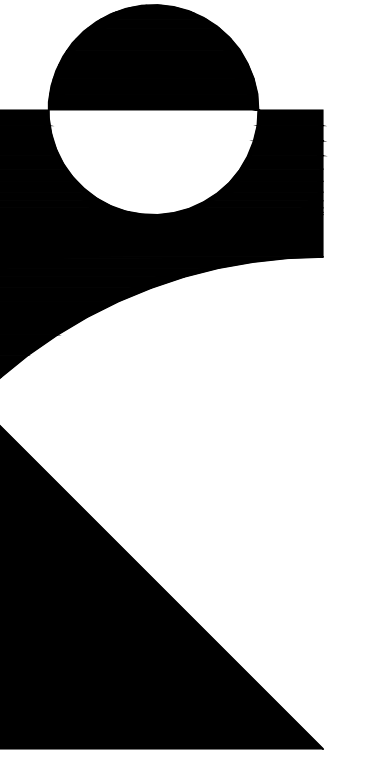


THINGS HOUSE IS ALL THINGS
R EVERY HOUSE OF FOR EVERY H
E ONE. HEBREWS 3: FOR EVERY
GOD. AS BUILT BY SOMEONE. THE
OUSE OF ALL THINGS IS GOD. H
E BUILT BY SOMEONE. BU THE BUI
BUILT BY SOMEONE. BU GOD. HEB
BUILT BY SOMEONE. BU GOD. HEB
RWS 3: FOR EVERY HOUSE IS B
HE BUILT BY SOMEONE. THE BUIL
HT BY SOMEONE. THE BUILT B

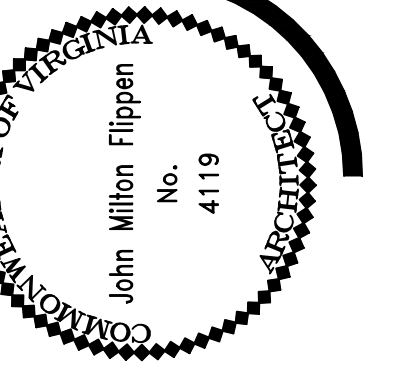

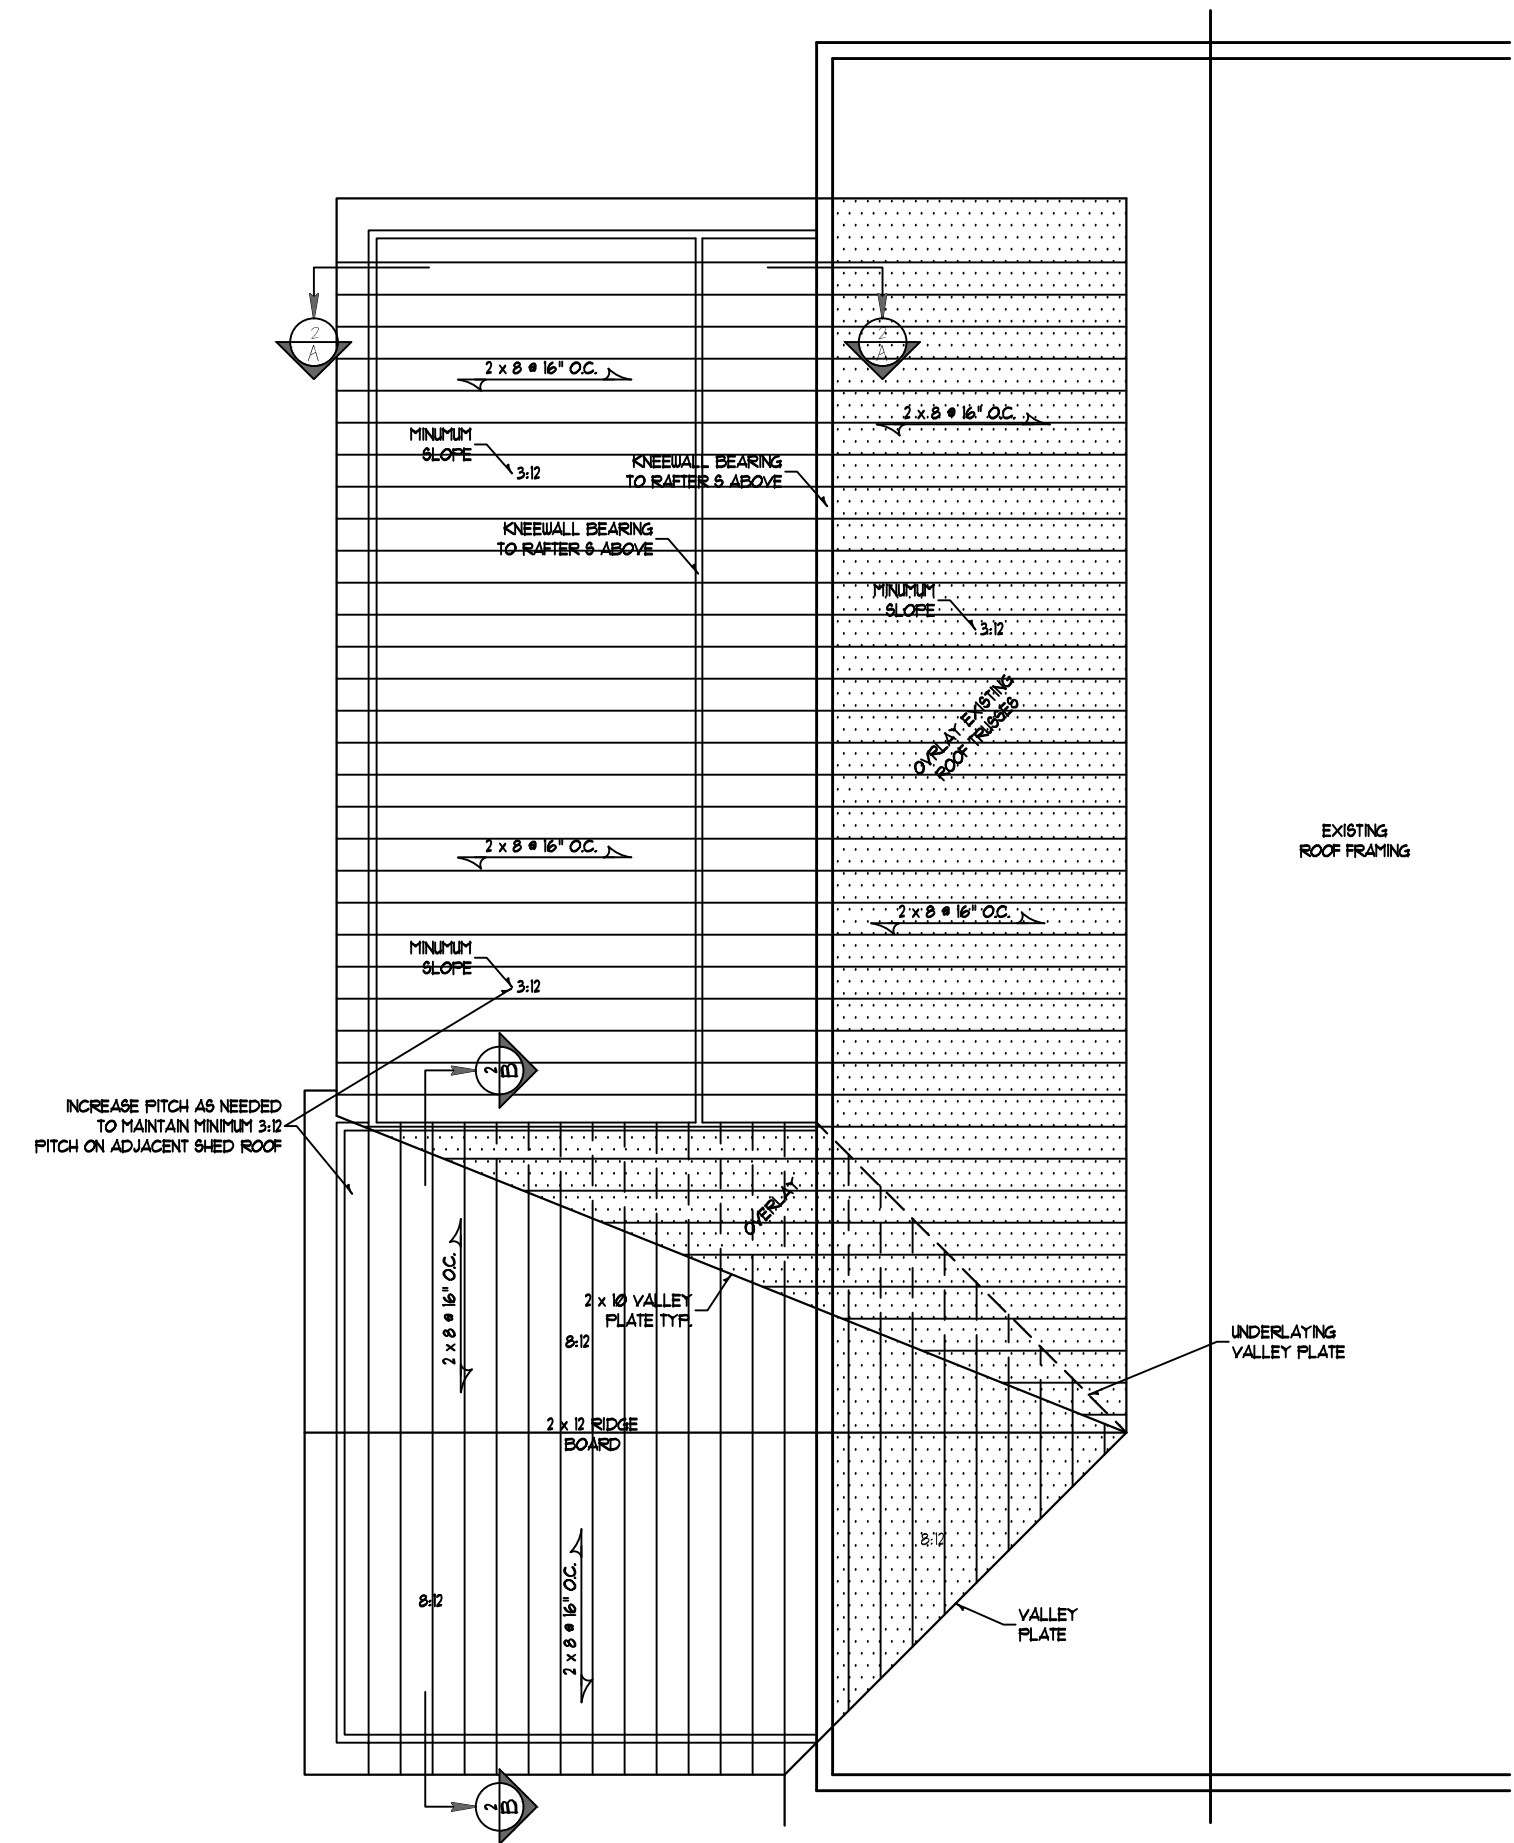

ROOF PLAN BLDG 214

SCALE: 1/8" = 1'-0"

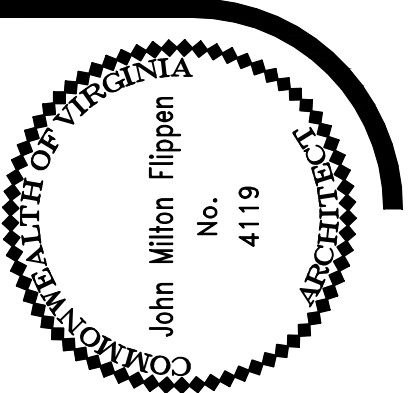


THINGS HOUSE IS ALL THINGS
 R EVERY BUILDER OF FOR EVERY H
 EON. HE BREWS 3:4 SOMEONE THE
 GOD. IS BUILT BY THINGS IS GOD. H
 OUSE OF ALL THINGS IS GOD. IS
 BREWS 3:4 SOMEONE. BU THE BUI
 BUILT BY SOMEONE. BU GOD. HEB
 LDER OF ALL THINGS IS HOUSE IS B
 R EW 3:4 SOMEONE THE BUILDERS
 LIT BY THINGS IS GOD. HEBRE B


OFFICE

1/4" = 1'-0"

john milton flippen
ARCHITECTURE
 280 river road west tel. (804) 784-7184
 goochland, virginia 23103 fax (804) 784-7186

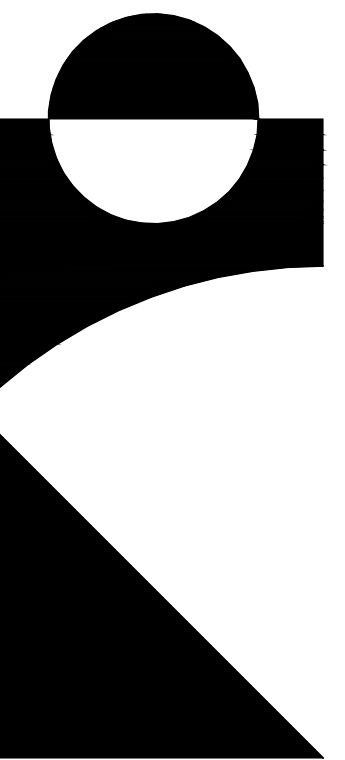


SHEET
4
 of **5**

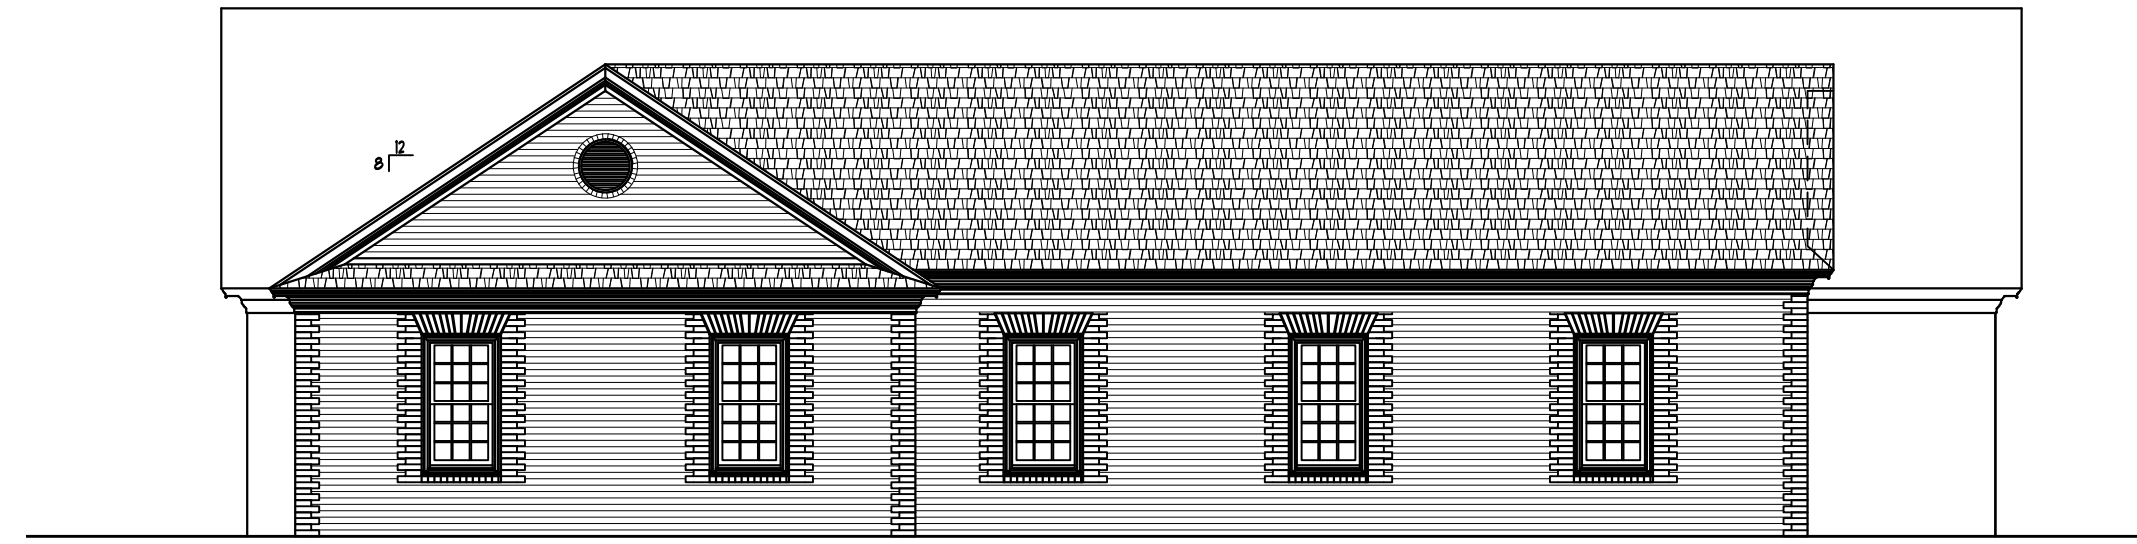


NORTH ELEV. BLDG 216

SCALE: 1/8" = 1'-0"

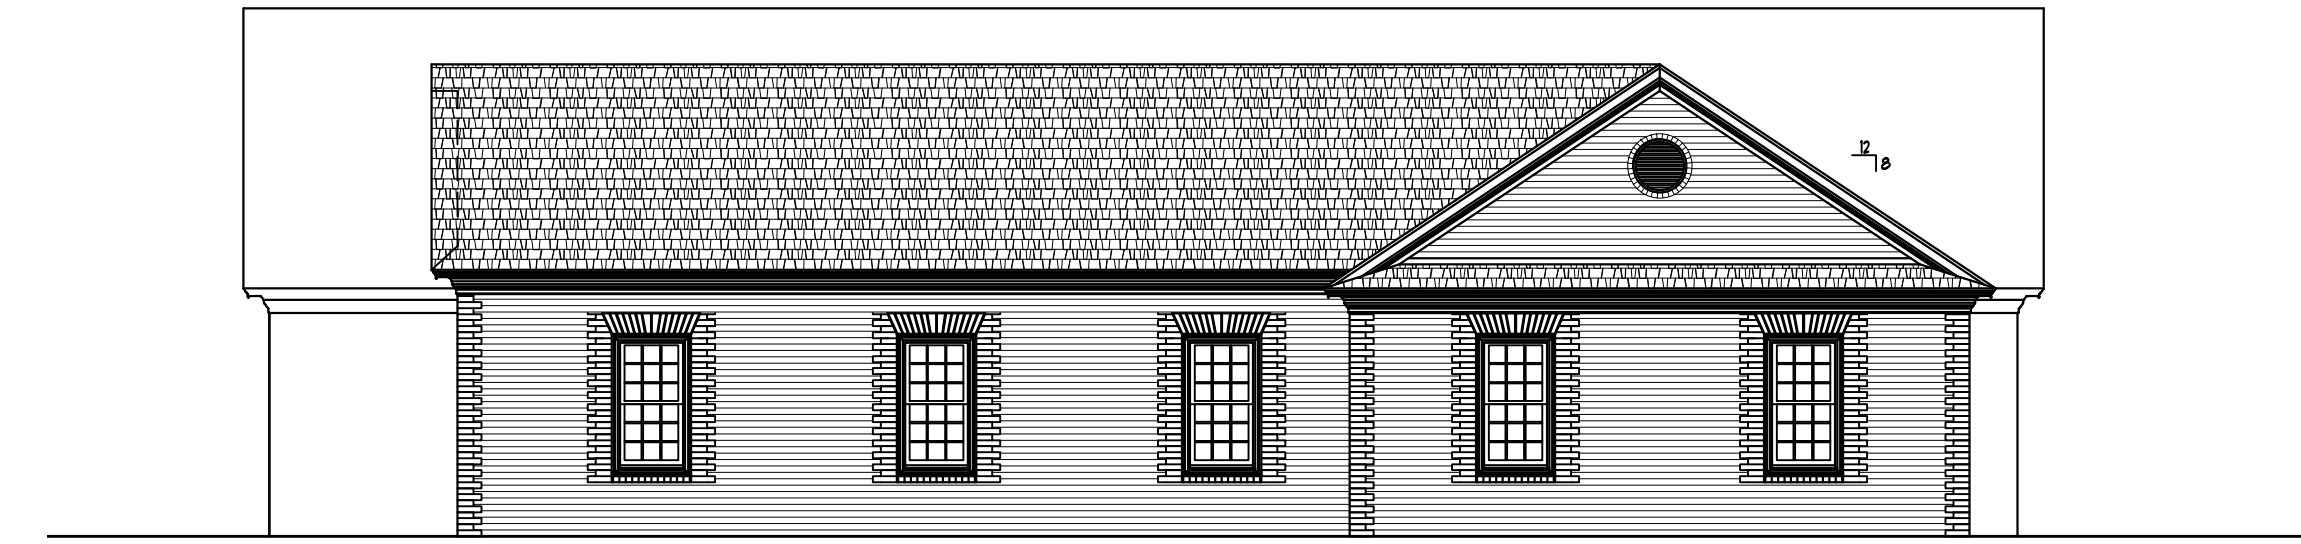



NORTH ELEV. BLDG 214

SCALE: 1/8" = 1'-0"

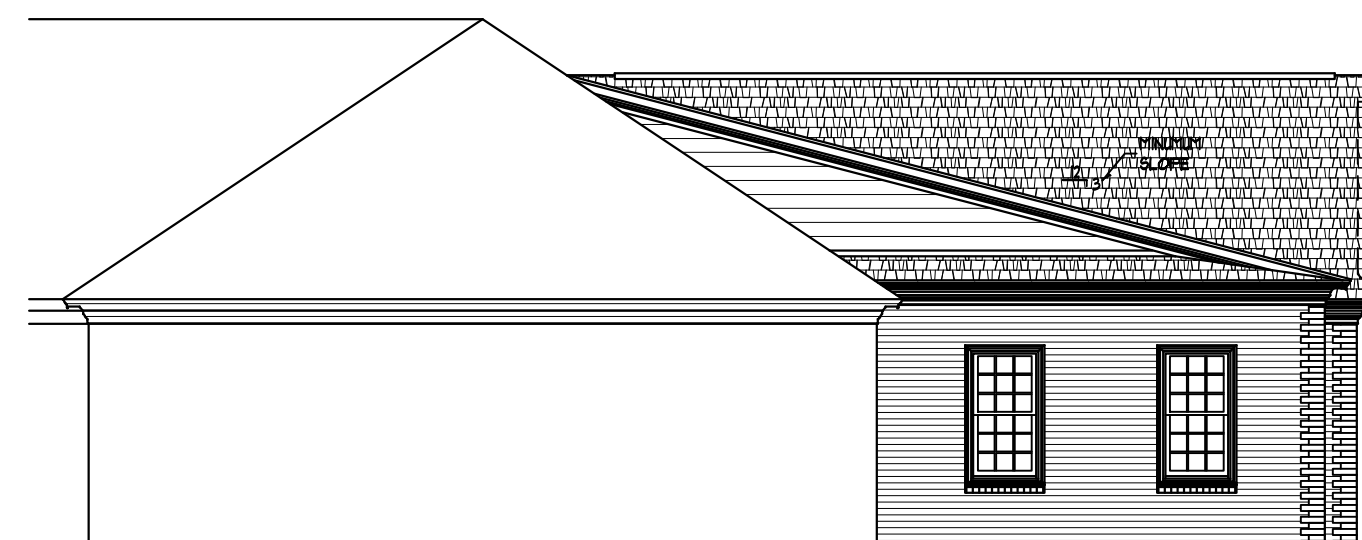


REAR ELEVATION

SCALE: 1/4" = 1'-0"

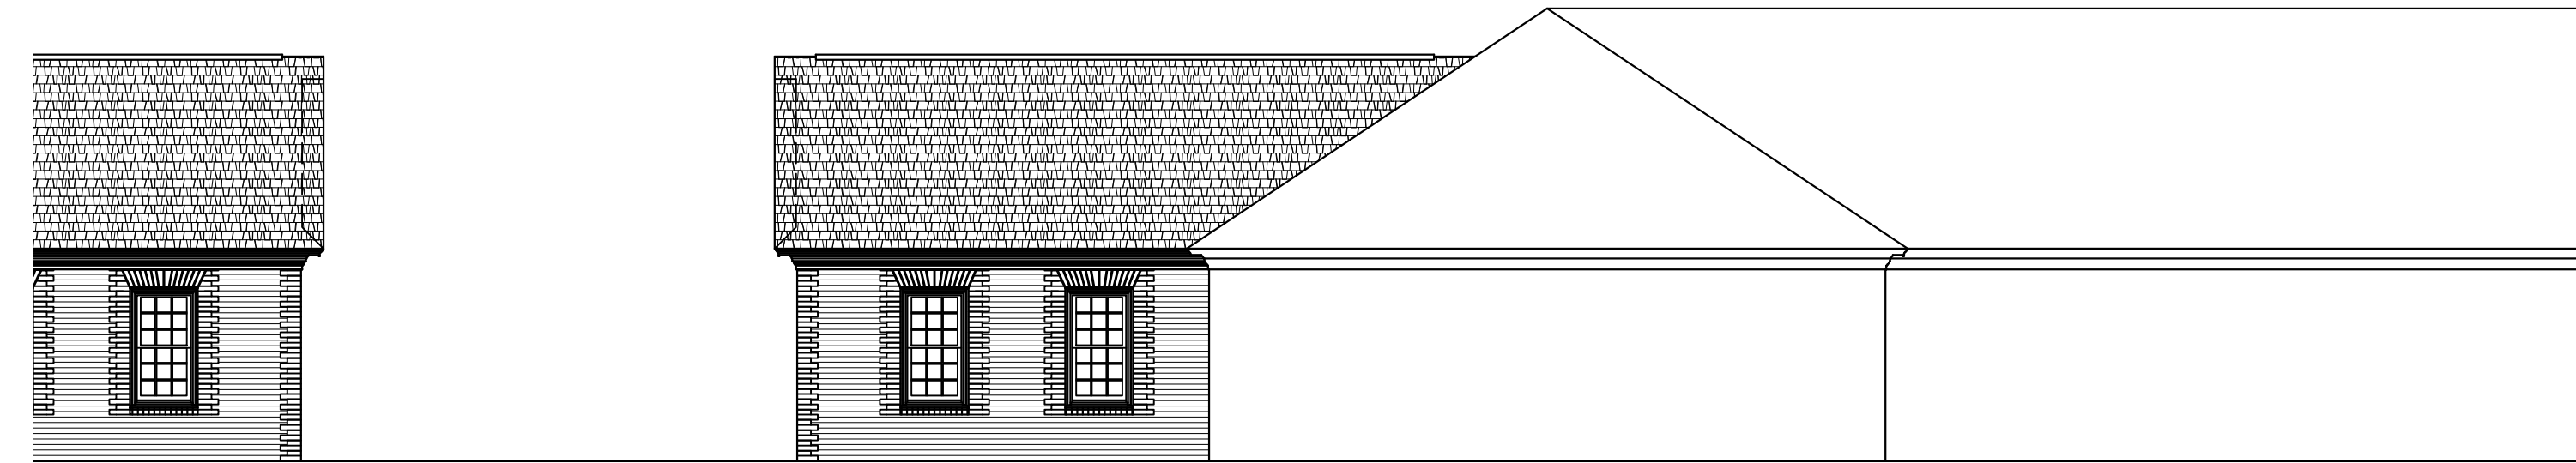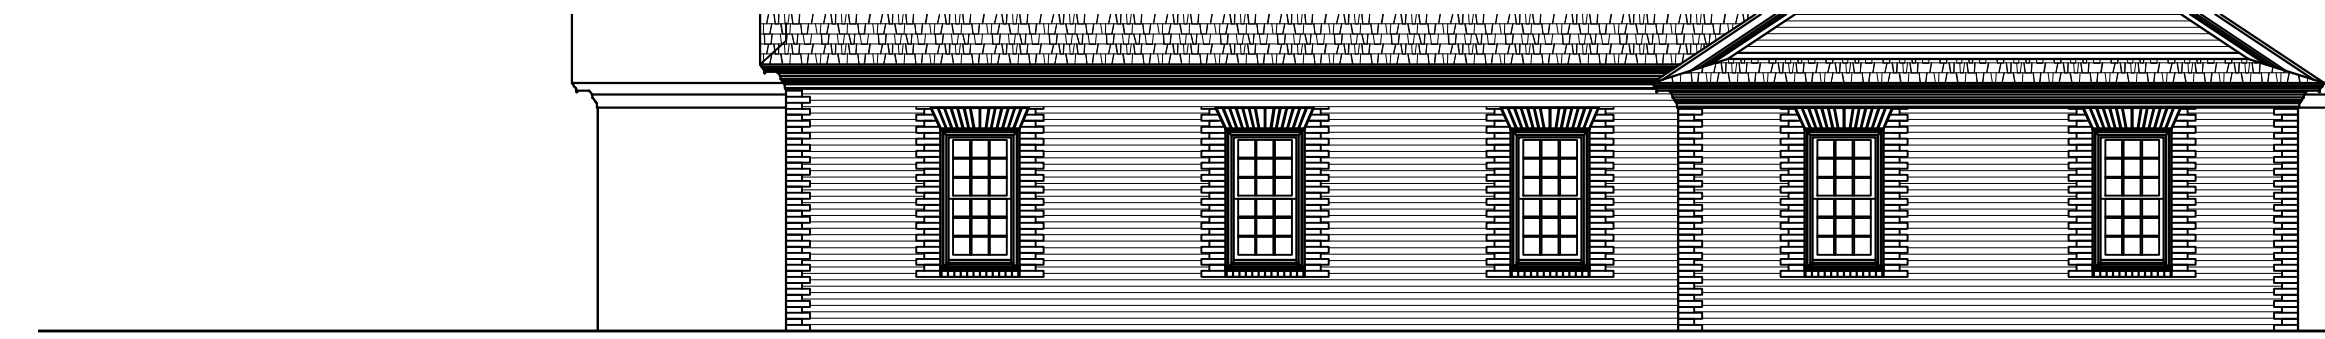

FRONT ELEVATION

SCALE: 1/4" = 1'-0"

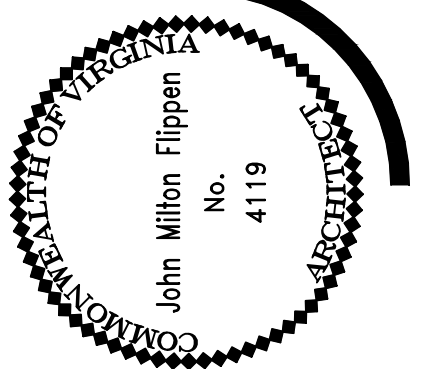

THINGS HOUSE IS ALL THINGS
 REVERE. BUILDER OF FOR EVERY H
 EONE. HEBREWS 3:3 SOMEONE. THE
 GOD. IS BUILT BY SOMEONE. H
 OUSER OF ALL THINGS IS GSE IS
 BUILT BY SOMEONE. BU THE BUI
 BUILT BY SOMEONE. BU THE BUI
 REVERE. BUILDER OF FOR EVERY H
 EONE. HEBREWS 3:3 SOMEONE. THE
 GOD. IS BUILT BY SOMEONE. H
 OUSER OF ALL THINGS IS GSE IS
 BUILT BY SOMEONE. BU THE BUI
 BUILT BY SOMEONE. BU THE BUI

OFFICE
 1/4" = 1'-0"

john milton flippen
ARCHITECTURE
 280 river road west tel. (804) 784-7184
 goochland, virginia 23103 fax (804) 784-7186

